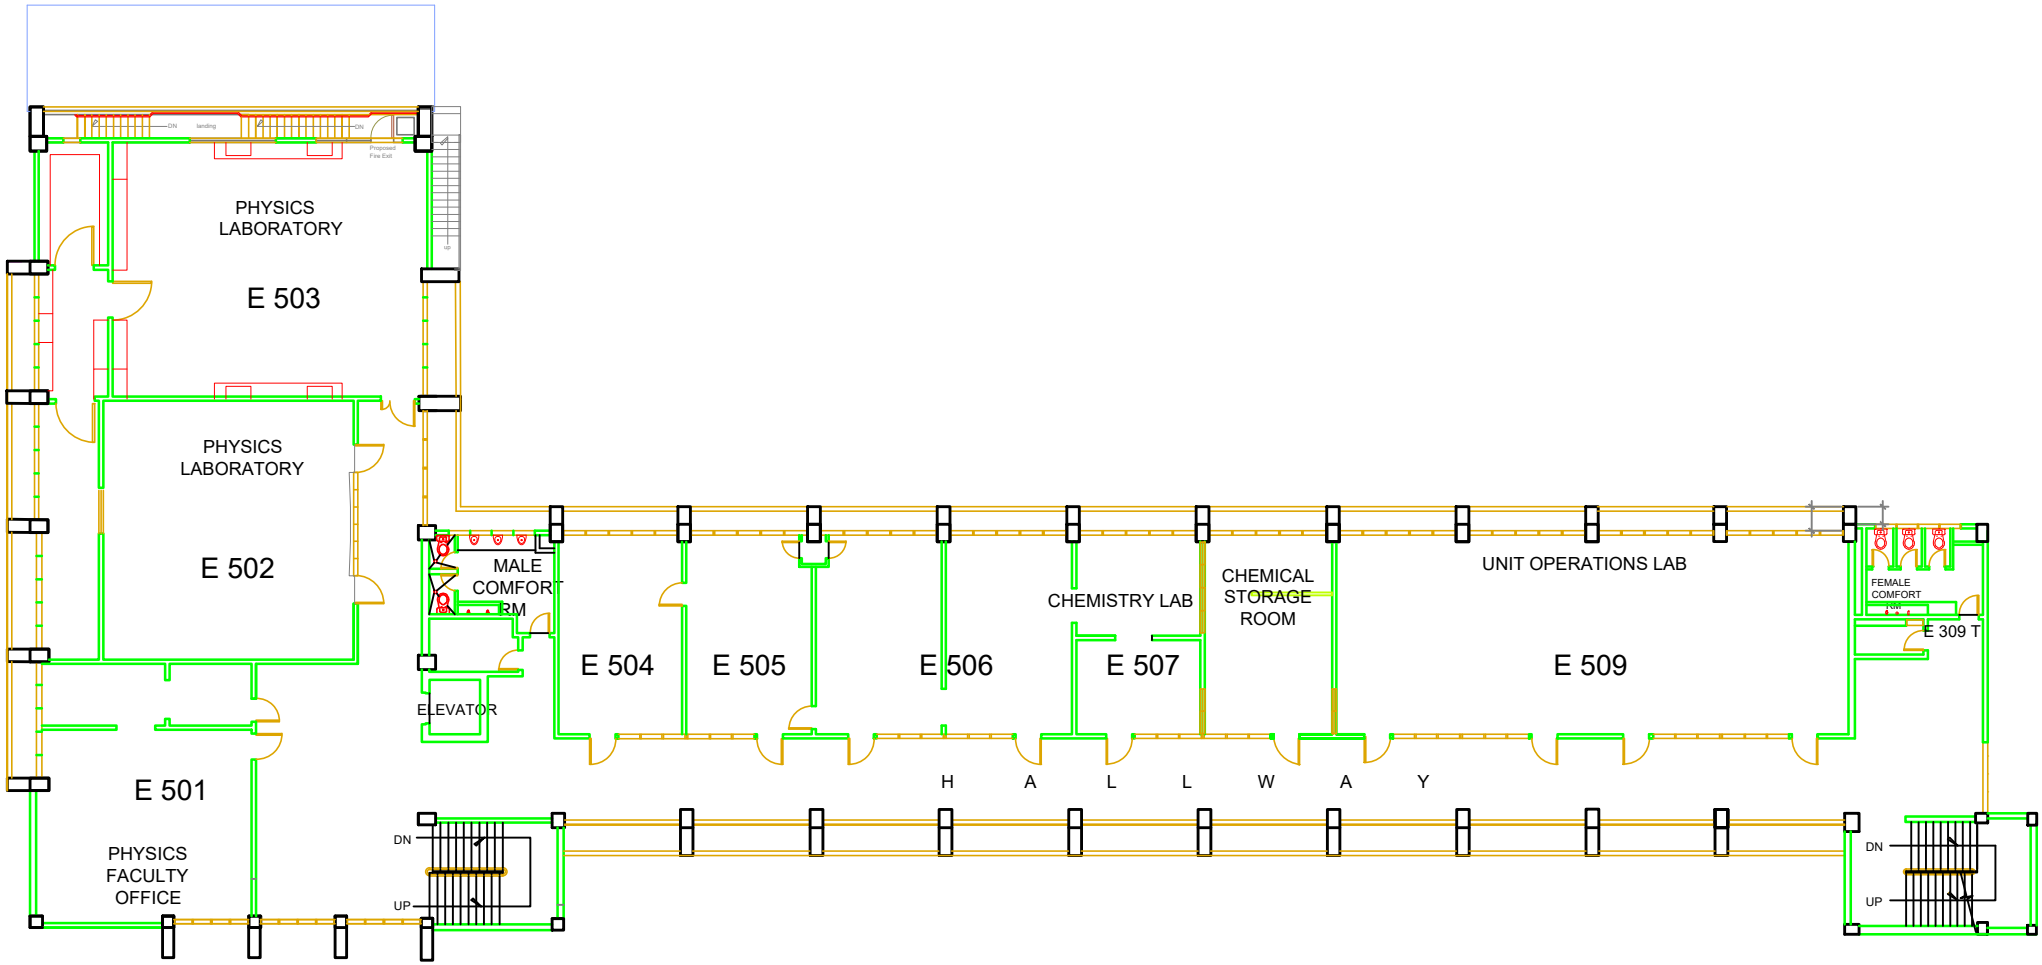


FIFTH FLOOR PLAN

SCALE 1:150 MTS

FROM THE OFFICE OF: XU PHYSICAL PLANT (XAVIER UNIVERSITY MAIN CAMPUS, CAGAYAN DE ORO CITY)	PROJECT TITLE: AS BUILT PLAN ENGINEERING BUILDING AS OF 2012	NOTED BY: RAMIL L. PAJO, XU PHYSICAL PLANT DIRECTOR TEAM COORDINATOR	AS BUILT BY: LAWRENCE JEFFRY C. MACEREN, XU ARCHITECT CONSULTANT MANAGING ARCHITECT	SHEET DATA	SHEET NO. A-7
	LOCATION: XAVIER UNIVERSITY MAIN CAMPUS, CAGAYAN DE ORO CITY			FILE DIRECTORY: R:\ARKFILES	
	OWNER: XAVIER UNIVERSITY			FILE NAME: ENGINEERING BLDG	
				DATE CREATED: DECEMBER 2007	
				LAST EDITED: NOVEMBER 2008	
				PRINTED ON:	
				ENCODED BY:	