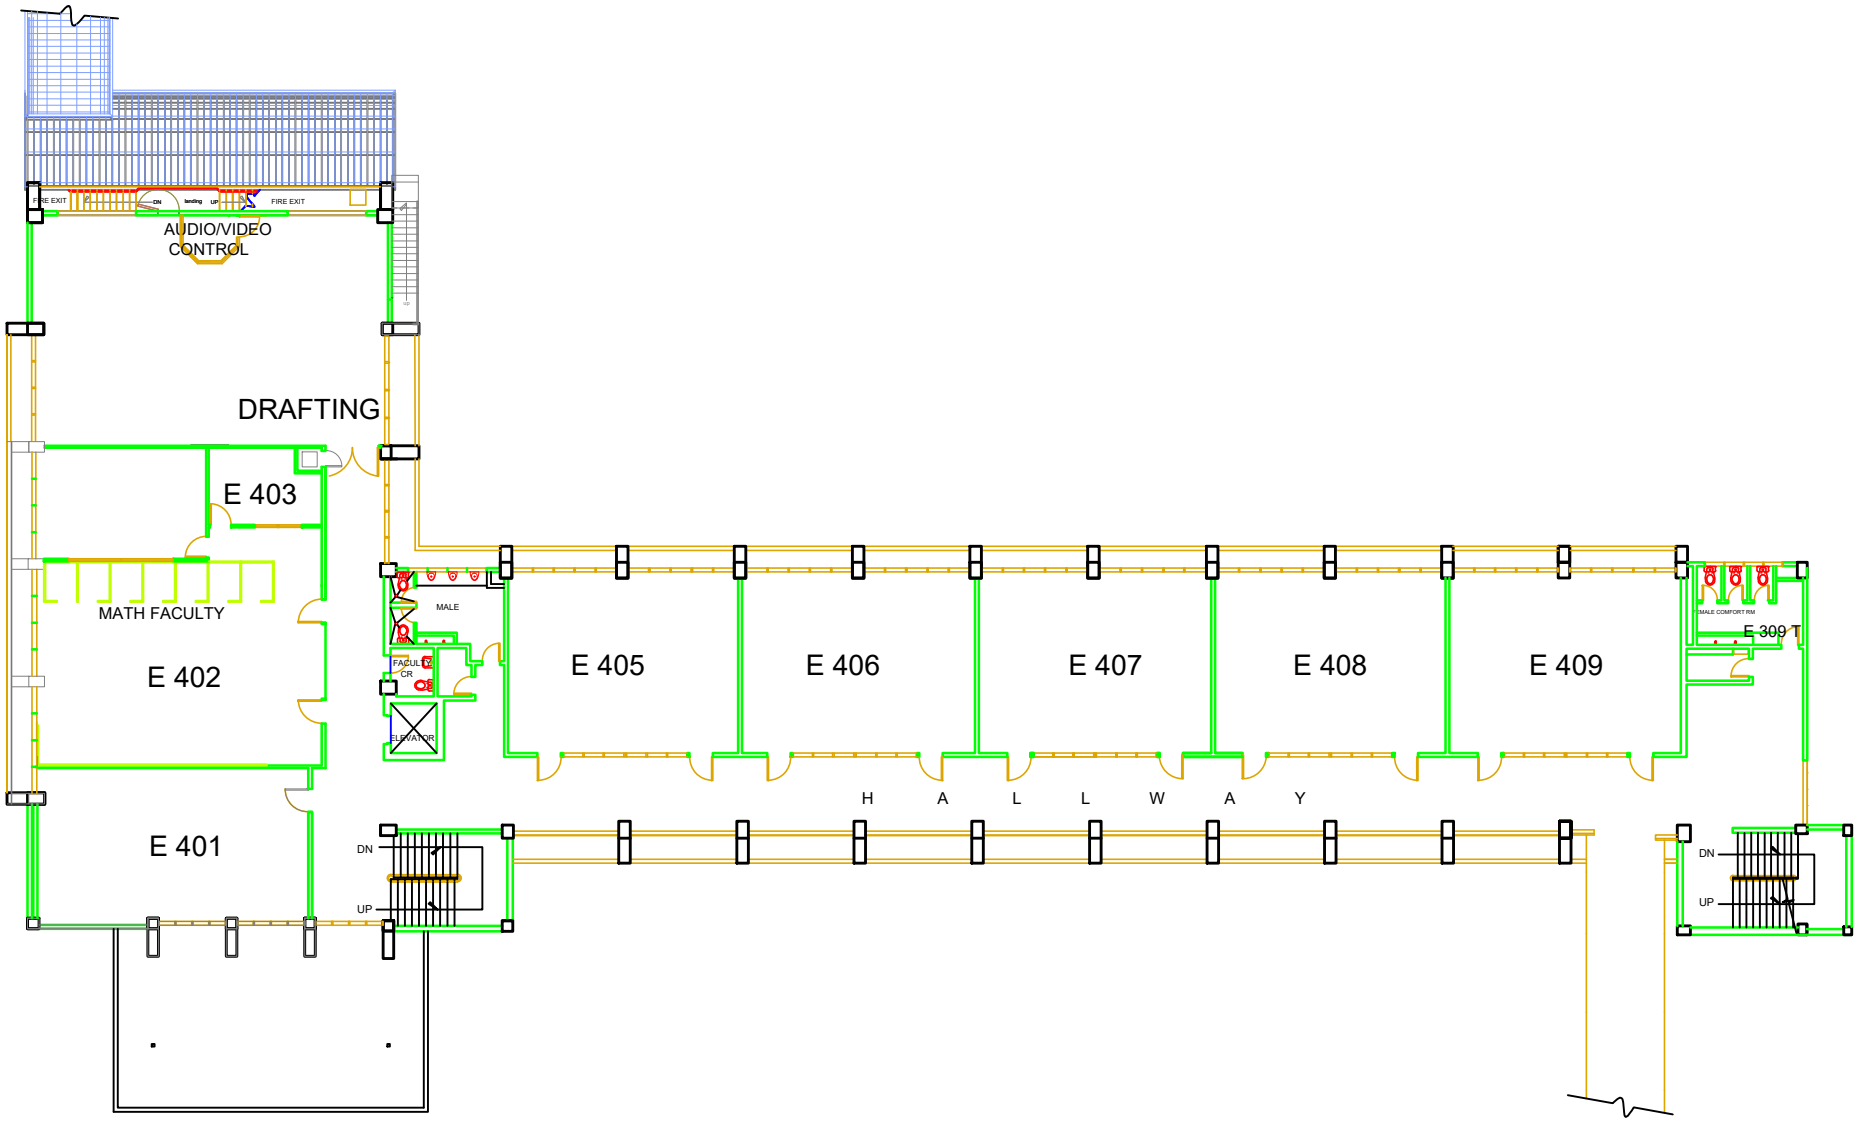


FOURTH FLOOR PLAN

SCALE 1:150 MTS

FROM THE OFFICE OF: XU PHYSICAL PLANT, XAVIER UNIVERSITY MAIN CAMPUS, CAGAYAN DE ORO CITY	PROJECT TITLE: AS BUILT PLAN ENGINEERING BUILDING, AS OF 2012, LOCATION: XAVIER UNIVERSITY MAIN CAMPUS, CAGAYAN DE ORO CITY, OWNER: XAVIER UNIVERSITY	NOTED BY: RAMIL L. PAJO, XU PHYSICAL PLANT DIRECTOR TEAM COORDINATOR	AS BUILT BY: LAWRENCE JEFFRY C. MACEREN, XU ARCHITECT CONSULTANT MANAGING ARCHITECT	SHEET DATA: FILE DIRECTORY: D:\WKFILES; FILE NAME: ENGINEERING BLDG; DATE CREATED: DECEMBER 2007; LAST EDITED: NOVEMBER 2008; PRINTED ON:; ENCODED BY:	SHEET NO.: A-6; 6 56