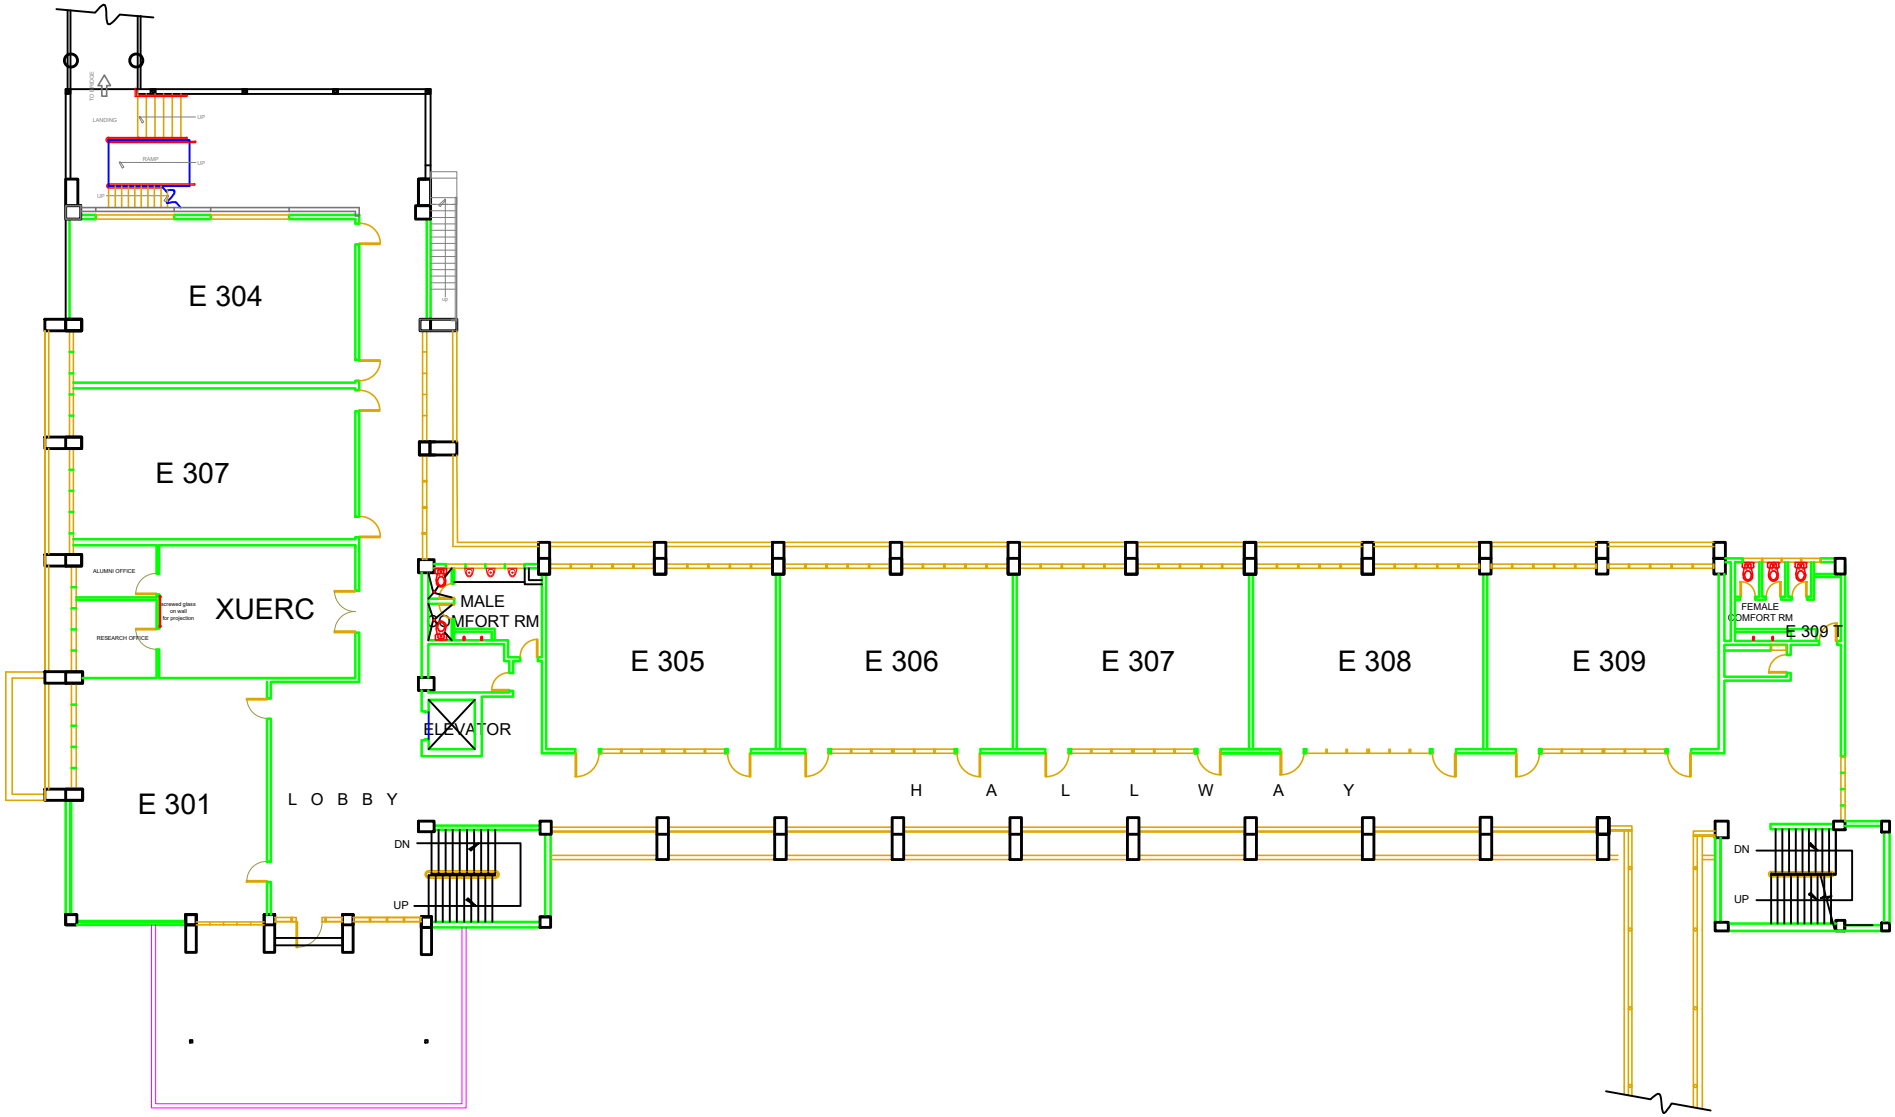


THIRD FLOOR PLAN

SCALE 1:150 MTS

FROM THE OFFICE OF:	PROJECT TITLE:	NOTED BY:	AS BUILT BY:	SHEET DATA	SHEET NO.
XU PHYSICAL PLANT XAVIER UNIVERSITY MAIN CAMPUS, CAGAYAN DE ORO CITY	AS BUILT PLAN ENGINEERING BUILDING AS OF 2012 LOCATION: XAVIER UNIVERSITY MAIN CAMPUS, CAGAYAN DE ORO CITY OWNER: XAVIER UNIVERSITY	RAMIL L. PAJO XU PHYSICAL PLANT DIRECTOR TEAM COORDINATOR	LAWRENCE JEFFRY C. MACEREN XU ARCHITECT CONSULTANT MANAGING ARCHITECT	FILE DIRECTORY: D:\WKFILES FILE NAME: ENGINEERING BLDG DATE CREATED: DECEMBER 2007 LAST EDITED: NOVEMBER 2008 PRINTED ON: ENCODED BY:	A-5 5 56