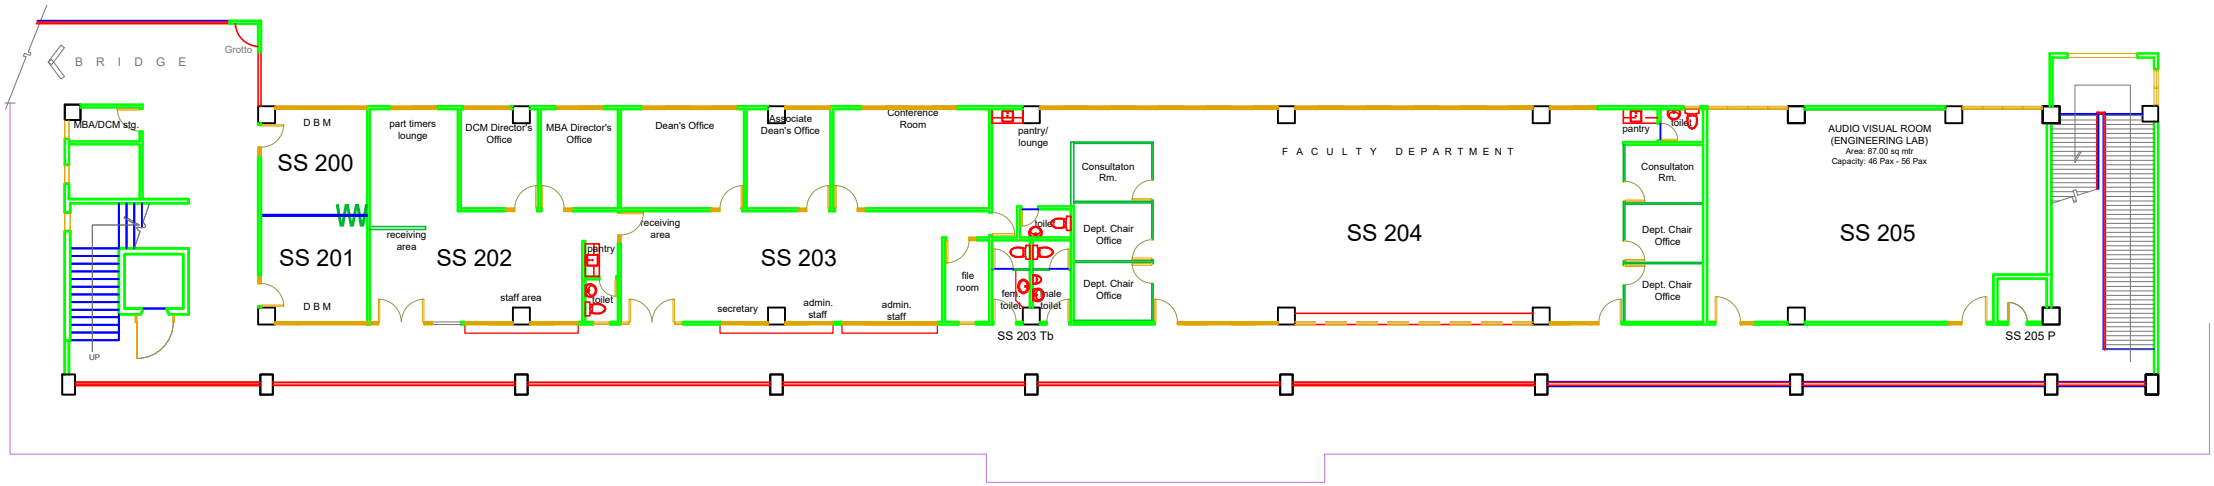


SECOND FLOOR PLAN

0 1 2 5 15

FROM THE OFFICE OF:	PROJECT TITLE:	NOTED BY:	AS BUILT BY:	SHEET DATA	SHEET NO.
XU PHYSICAL PLANT XAVIER UNIVERSITY MAIN CAMPUS, CAGAYAN DE ORO CITY	AS BUILT PLAN SCHOOL OF BUSINESS & MANAGEMENT BLDG LOCATION: XAVIER UNIVERSITY MAIN CAMPUS, CAGAYAN DE ORO CITY OWNER: XAVIER UNIVERSITY	EMELINDA BOMBEO XU PHYSICAL PLANT DIRECTOR TEAM COORDINATOR	LAWRENCE JEFFRY C. MACEREN XU ARCHITECT CONSULTANT MANAGING ARCHITECT	FILE DIRECTORY: D:\ARKFILES FILE NAME: COMMERCE BUILDING DATE CREATED: OCTOBER 2007 LAST EDITED: JUNE 19, 2014 PRINTED ON: ENCODED BY: JBA	A-3 3 53